

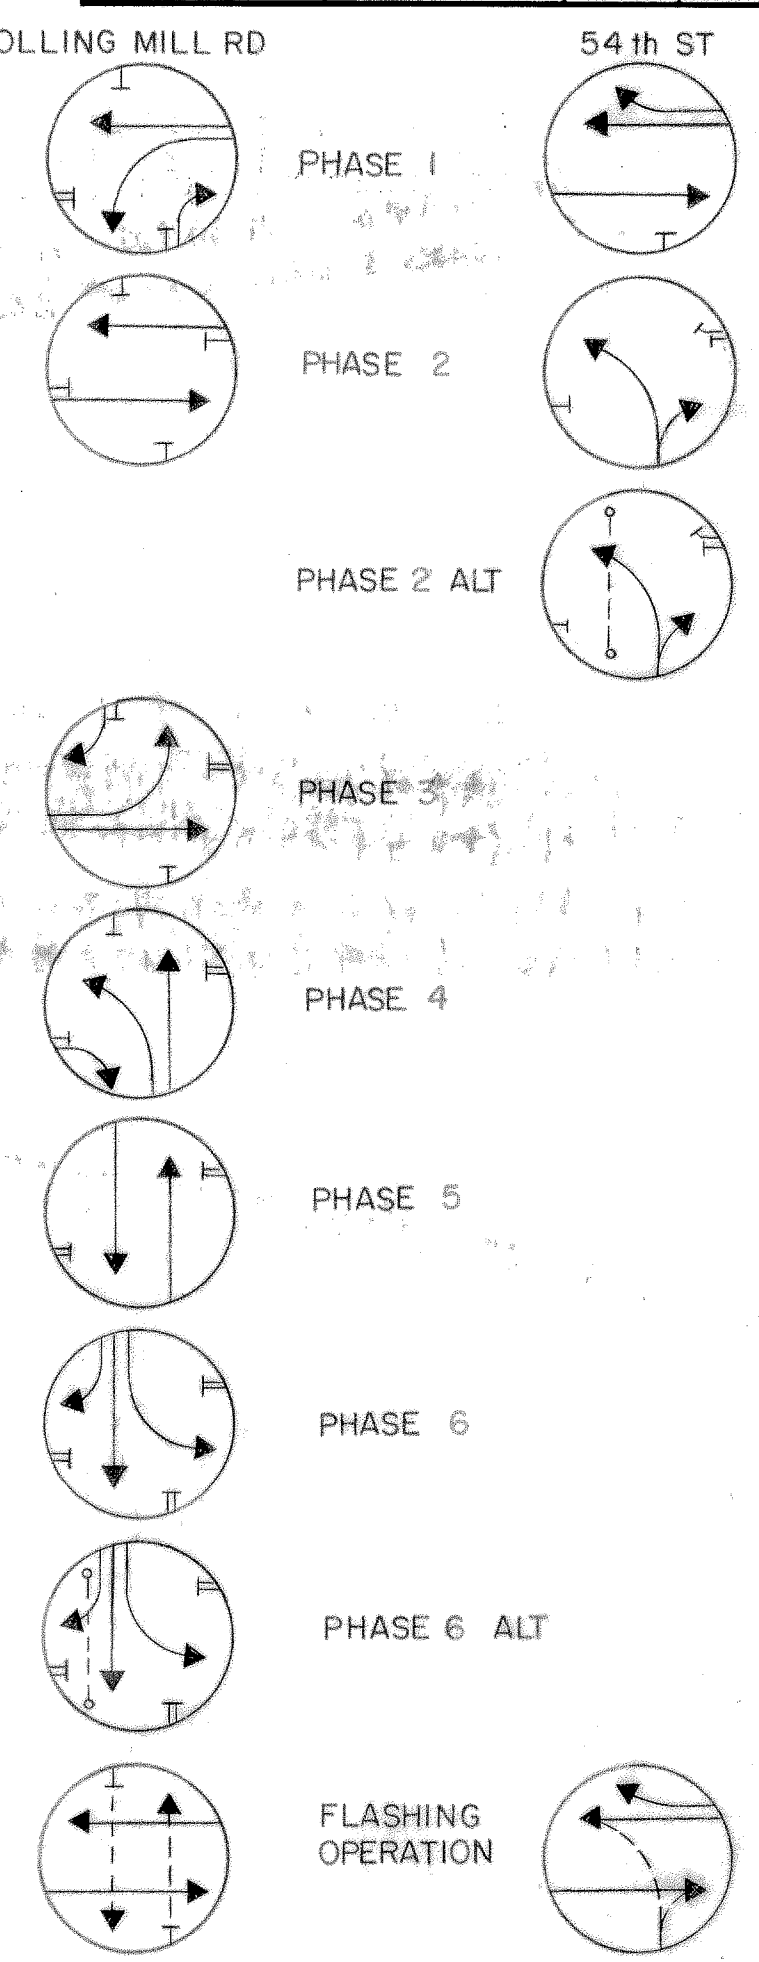


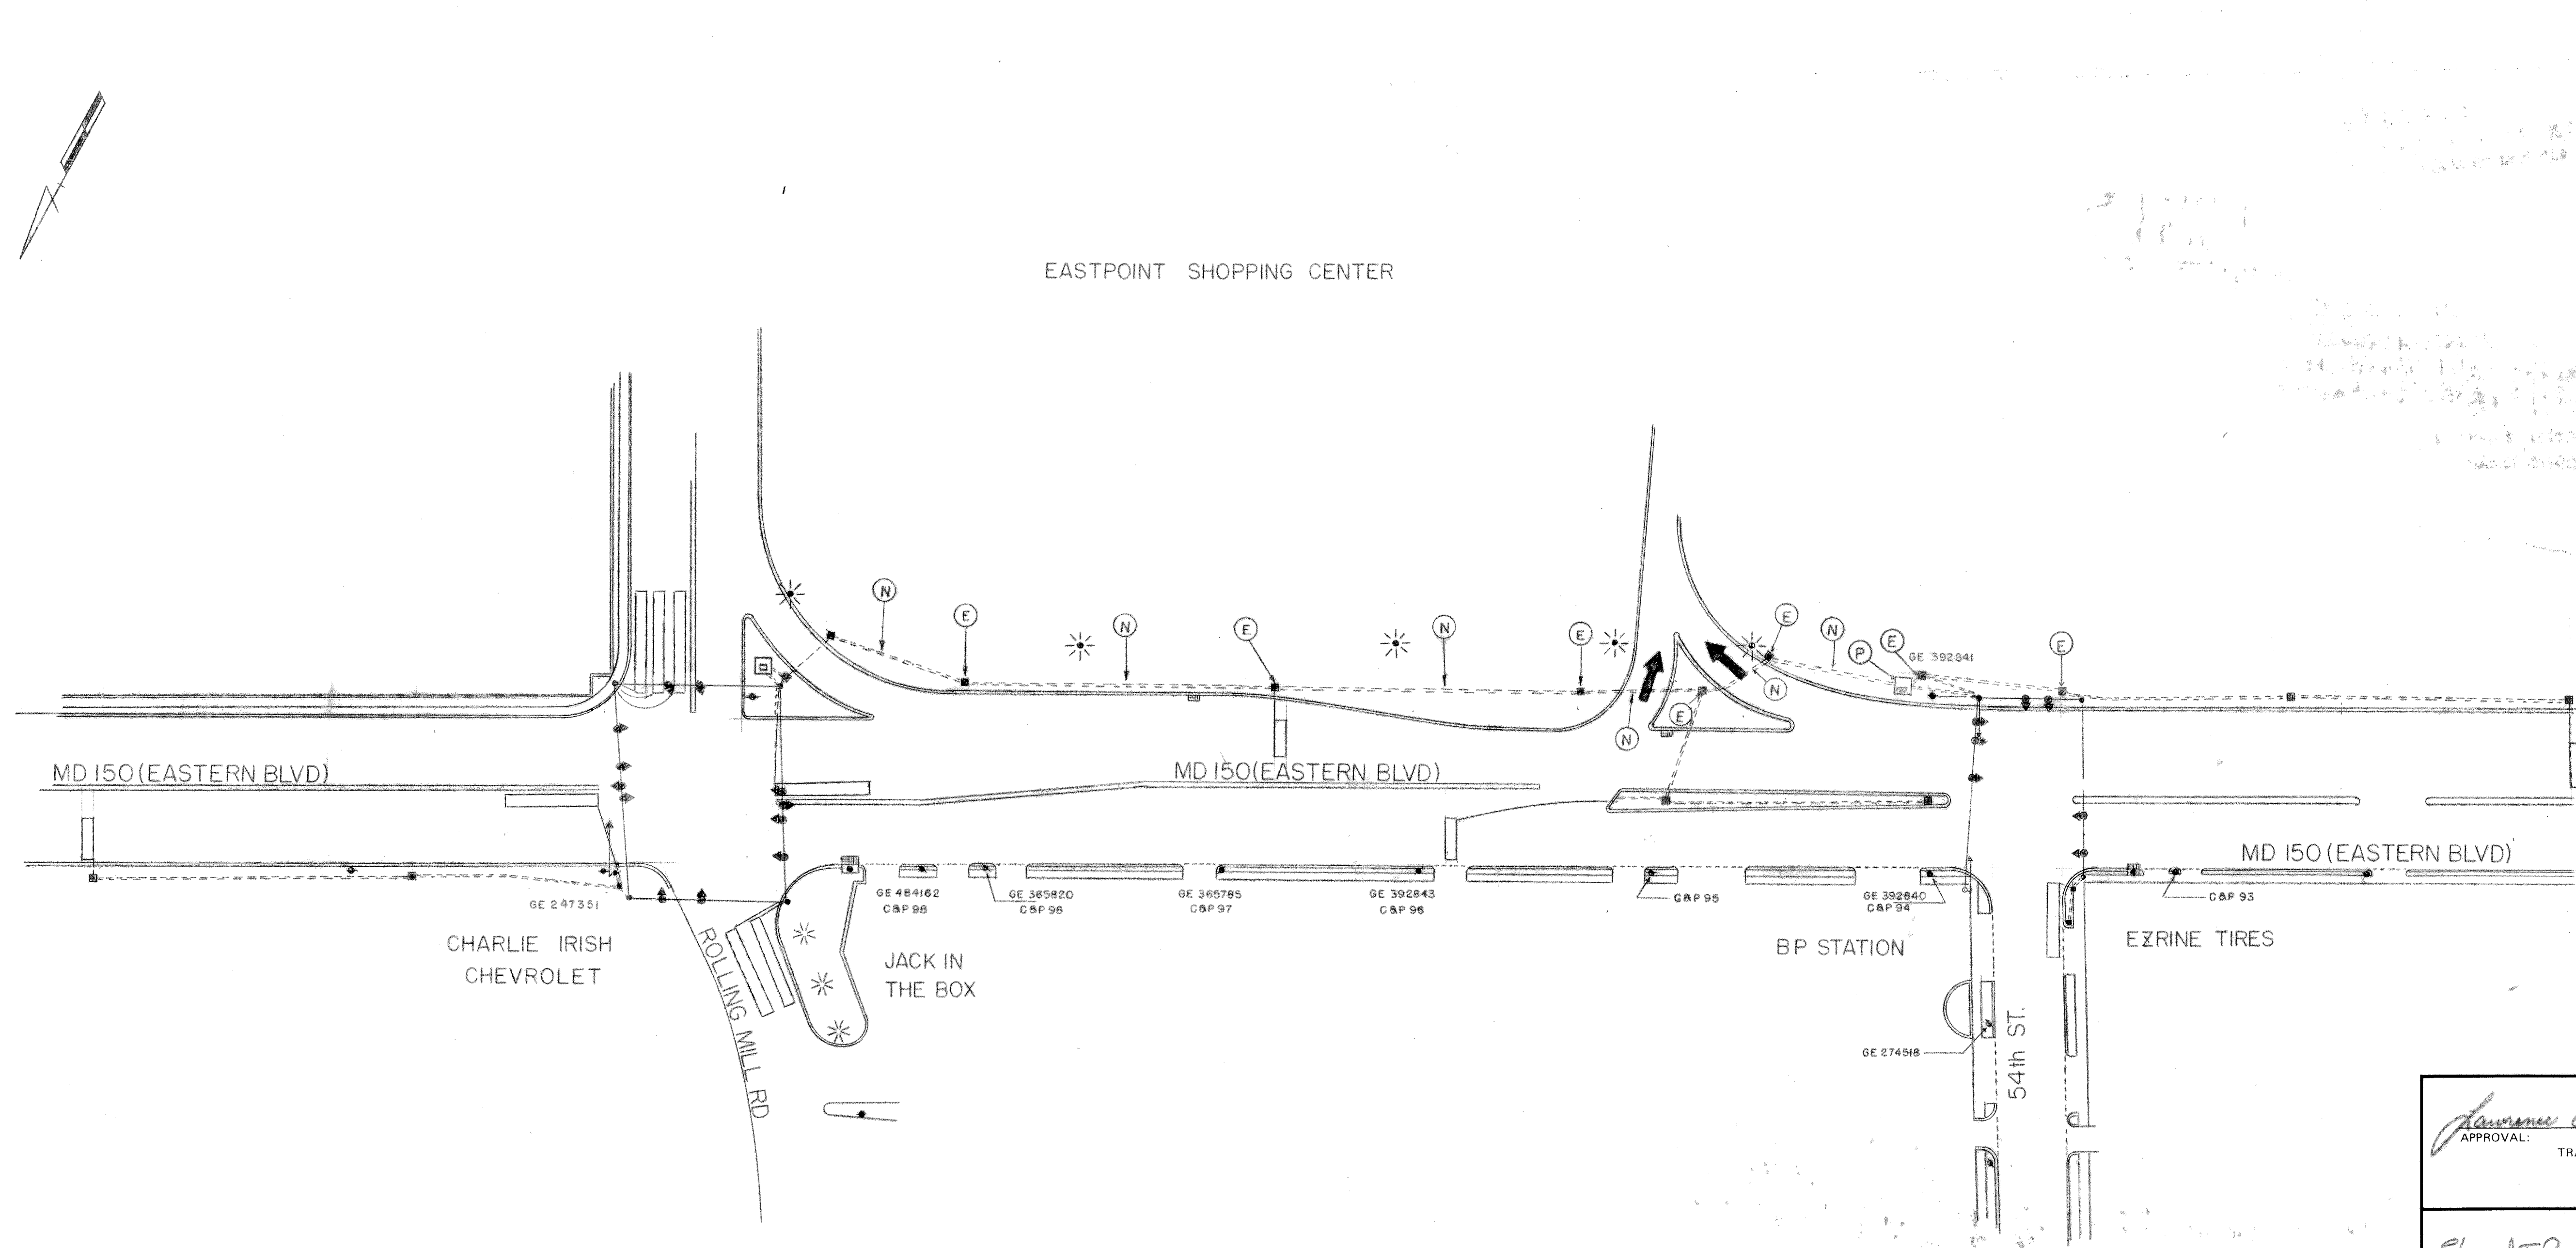

F.H.W.A. REGION NO.	STATE	FED. AID PROJ. NO.	SHEET NO.	TOTAL SHEETS
3	MD.			

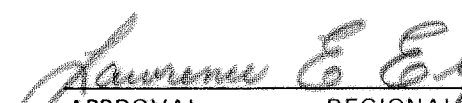

 APPROVAL: REGIONAL TRAFFIC ENGINEER								
 APPROVAL: CHIEF-BUREAU OF TRAFFIC ENGINEERING	DW 2/6/75							
 APPROVAL: ASST. CHIEF ENGINEER TRAFFIC	2/6/75							
A ASBUILT B 293X-000-485 WEM3 CTB RD REVISIONS	9/16/75							

STATE OF MARYLAND		
DEPARTMENT OF TRANSPORTATION		
STATE HIGHWAY ADMINISTRATION		
TRAFFIC DIVISION — BUREAU OF TRAFFIC ENGINEERING		
MD 150 (EASTERN BLVD) INTERCONNECT, FROM 54th ST TO ROLLING MILL ROAD		
SCALE	DATE	CONTRACT NO.
1" = 50'	5-28-73	
DRAWN BY: J. GORDON	COUNTY: BALTIMORE	
DESIGNED BY: J.H. O.S.	SIGNAL NO. 03092 & 03206	
CHECKED BY: A. Budnitschuk 2-14-74	DRAWING NO. TS- 923A	